

Appendix C : Existing Conditions Assessment

Appendix C Existing Conditions Assessment

INTRODUCTION

Overview

After an on-site visit and reviews of the existing Herschler Building drawings, we believe additional probes and investigations are required to further understand the as-built condition of the exterior enclosure. The following pages explain the areas and type of probes that will need to be conducted prior to providing final design solutions for the Existing Herschler exterior renovation.

Hazardous Materials

Due to the dates of construction, the Herschler building will require Hazardous Materials assessment, as will the site upon which it is located. Based on the findings in the assessment, abatement and remediation may be required prior to commencement of any further work. To ensure all areas are properly addressed, the assessment will investigate the site and the Herschler Building for hazardous materials including but not limited to: Asbestos, Lead, Mold, Polychlorinate Biphenyl [PCB], and Radon. Additional materials may be included in the assessment as recommended by the investigating consultant.



THIS PAGE INTENTIONALLY LEFT BLANK



Appendix C Existing Conditions Assessment

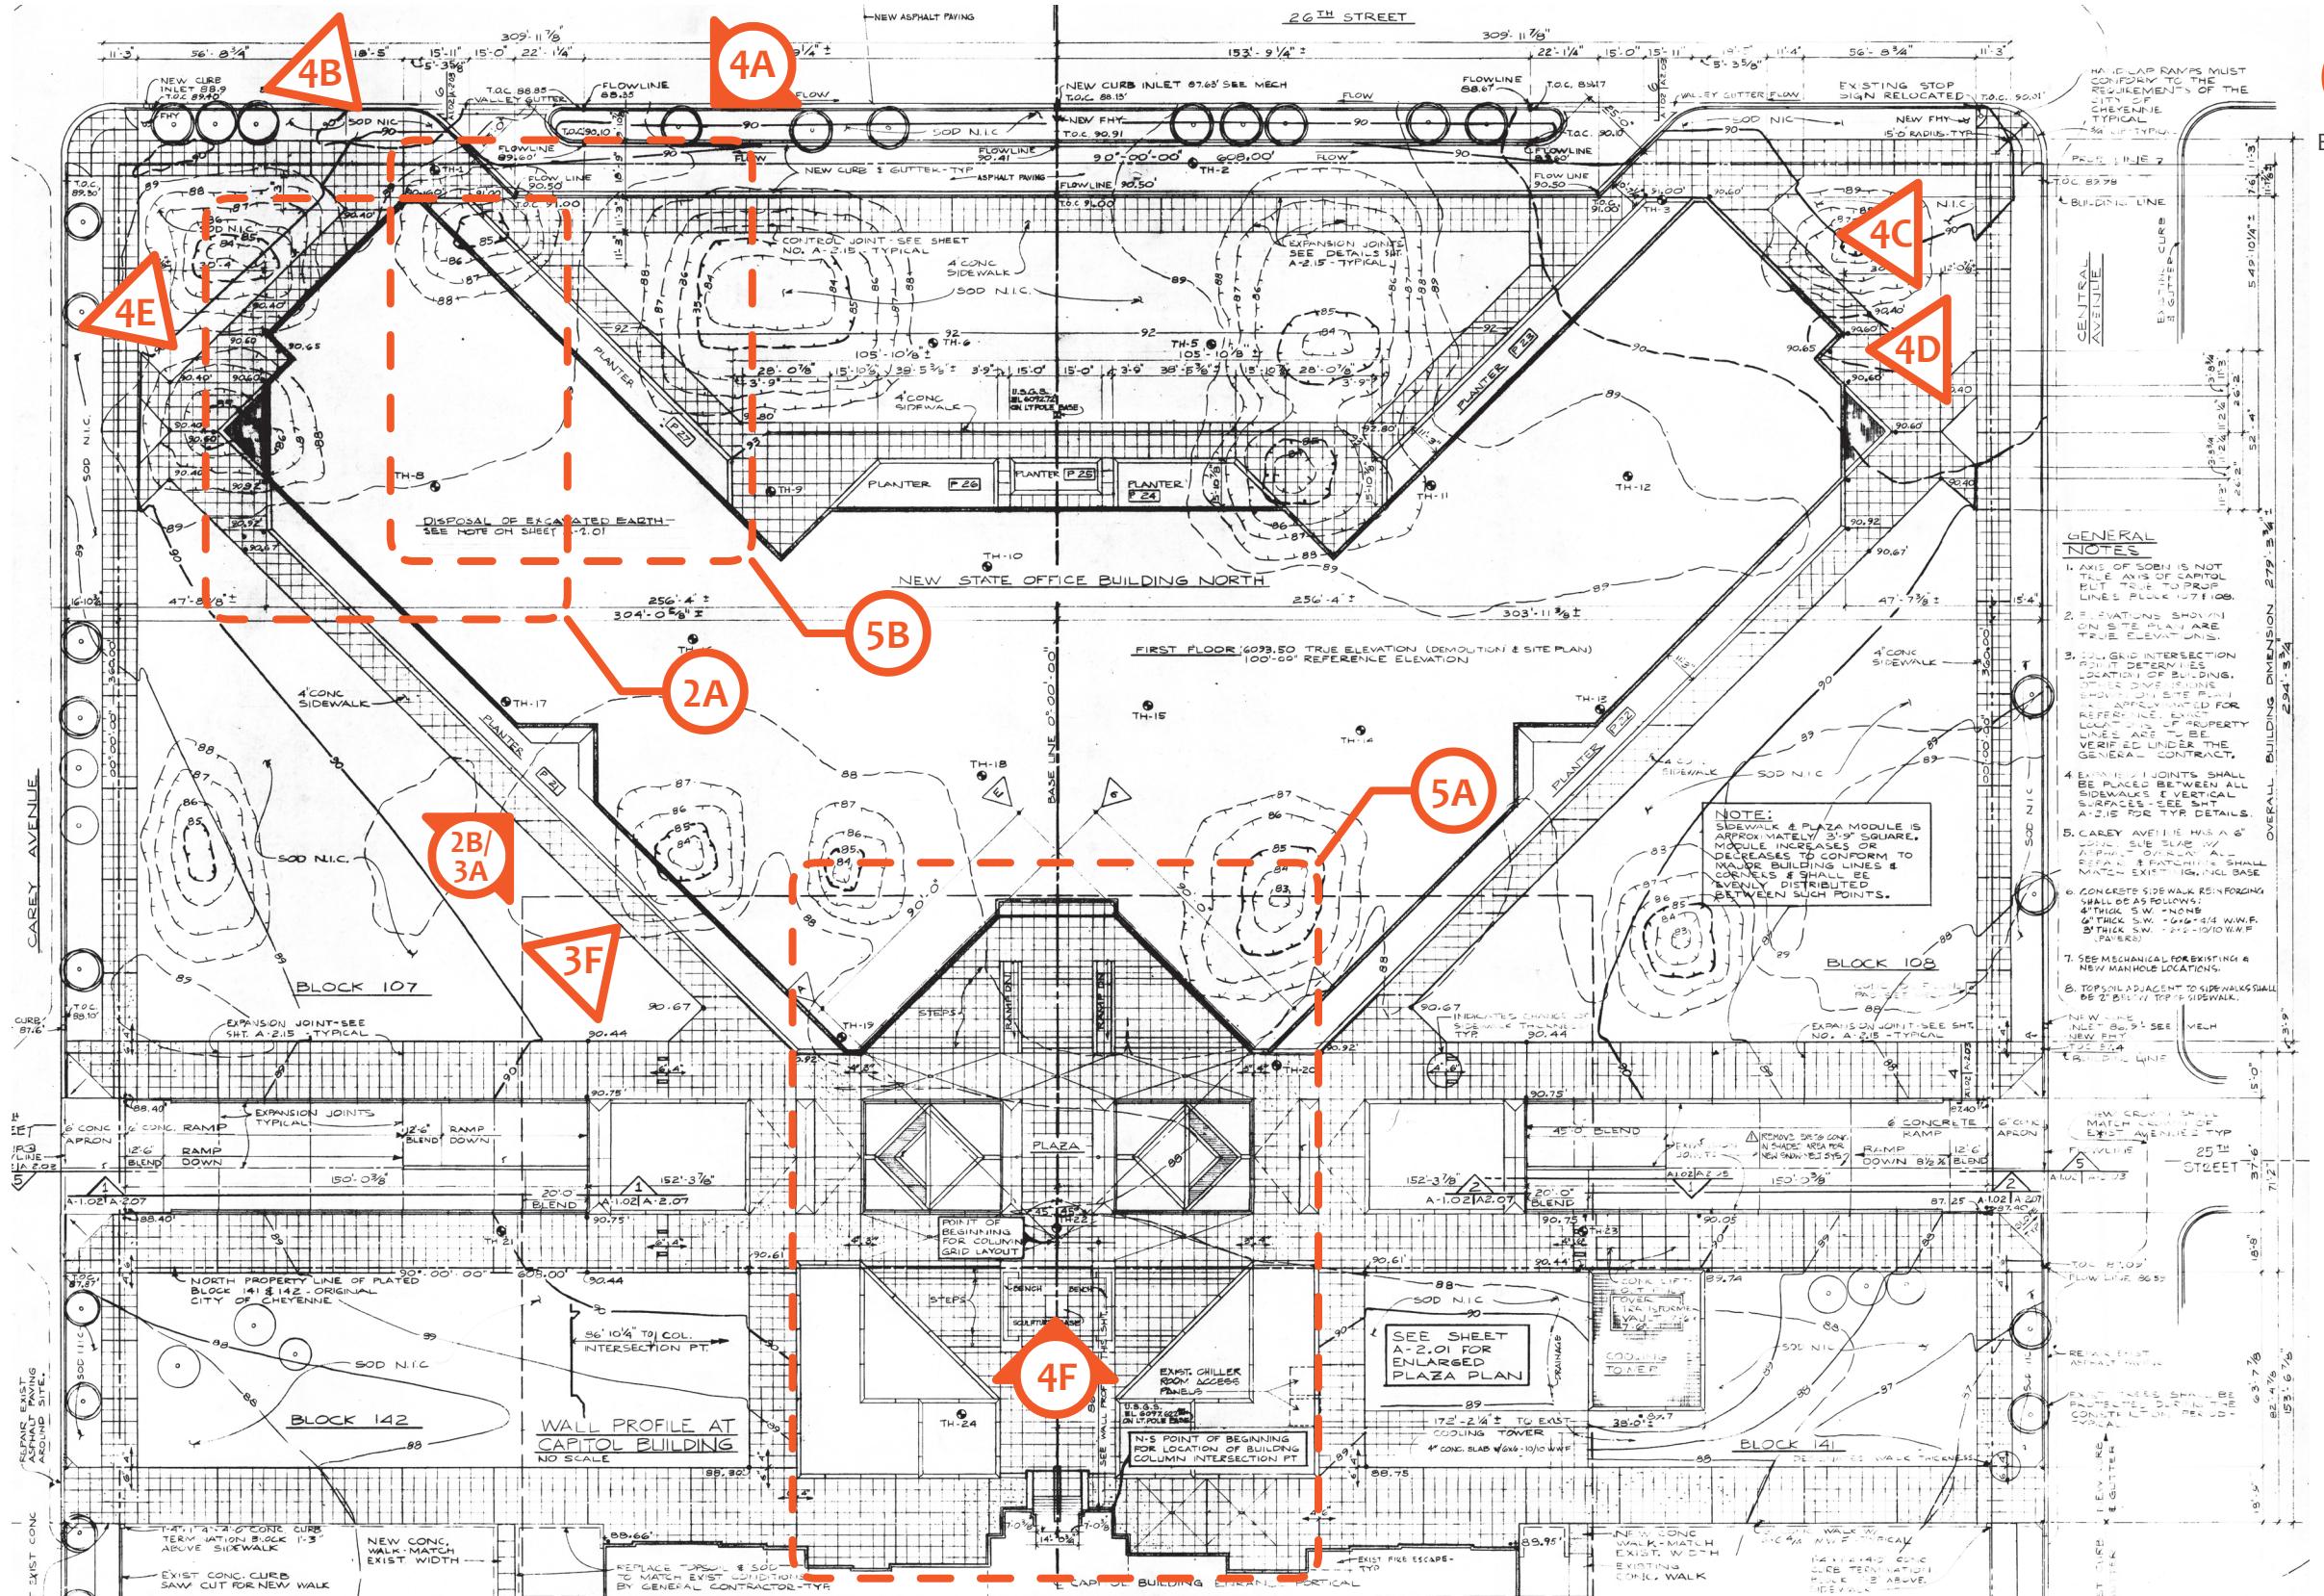


Figure C.01: Herschler Building - Overall Site Plan



Enlarged Plan

Appendix C Existing Conditions Assessment

PLANTER/ PRECAST FIN PROBE

Planters

Intent

The intent of the planter probe/exploration is to selectively remove various building components, landscape, and fill, to understand existing as-built conditions.

Goals

To understand the following as-built conditions:

- Problematic water infiltration into the building and parking structure below.
- The possible presence of mold.
- Condition of structural support elements.
- Extent and condition of insulation.
- Extent and condition of waterproofing and flashing.
- Presence of positive slope, direction of slope, and drainage type.

Precast Fins/ Limestone Panels

Intent

The intent of this probe/exploration is to remove one angular precast fin panel [jamb] and one adjacent limestone base panel. Additionally, remove one stand alone precast fin panel to understand existing as built conditions.

Goals

To understand the following as-built conditions:

- Connection/support of precast fin panels and limestone panels.
- Condition of adjacent precast panels at the exterior head and sill condition.
- The possible presence of mold.
- Condition of structural support elements.
- Extent and condition of insulation.
- Extent and condition of waterproofing and flashing.

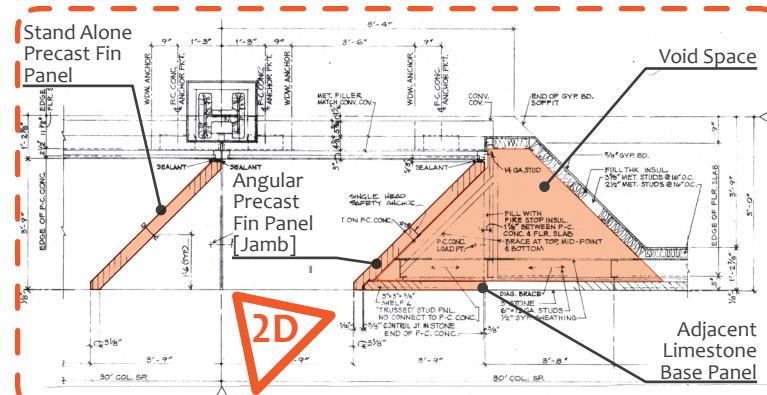


Figure C.02: Precast Fin Detail [Opposite Hand]

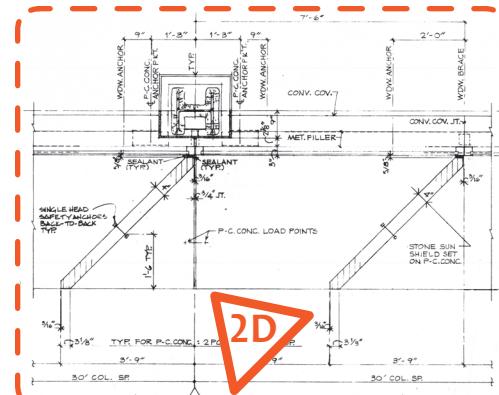


Figure C.05: Precast Fin Detail [Opposite Hand]

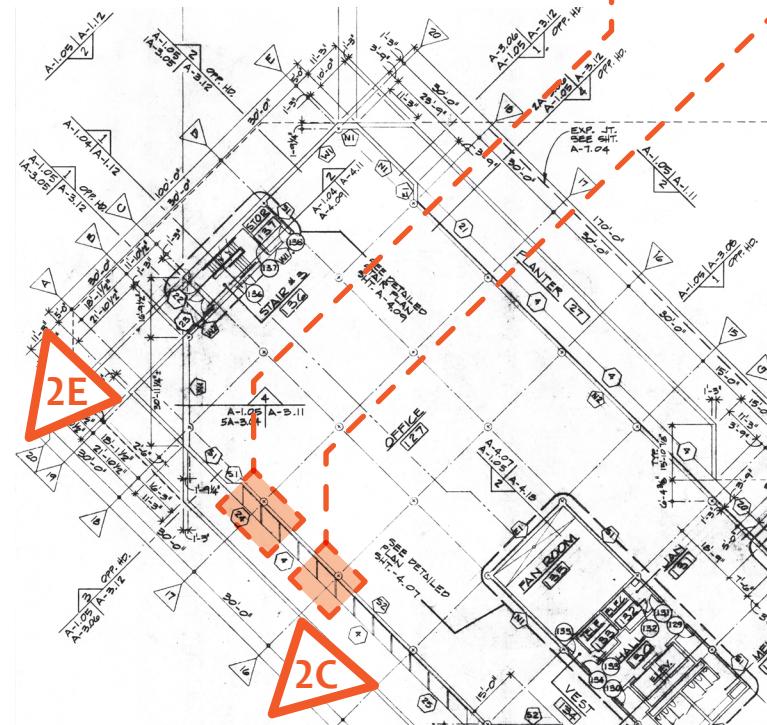


Figure C.03: Plan 2A - Partial First Level Floor Plan

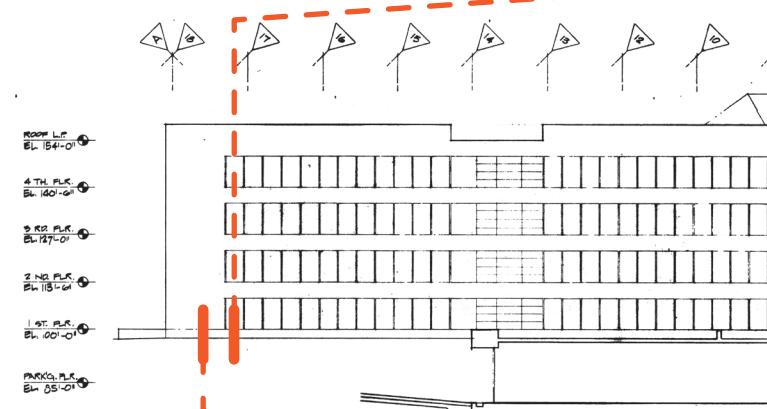


Figure C.04: Elevation 2B - Partial South Elevation

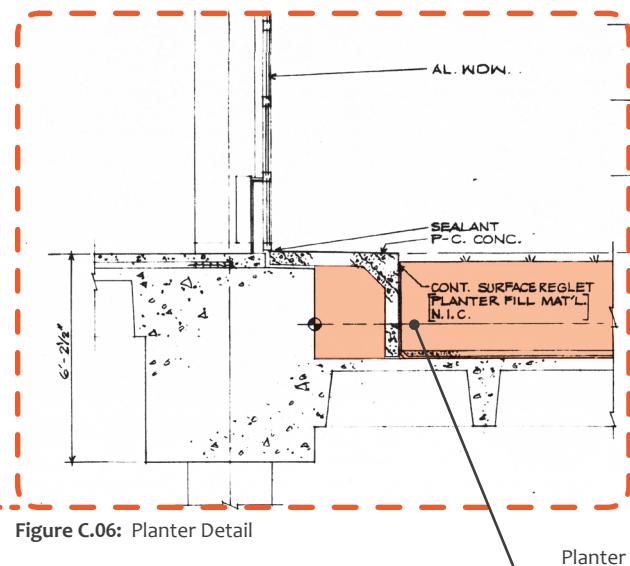


Figure C.06: Planter Detail

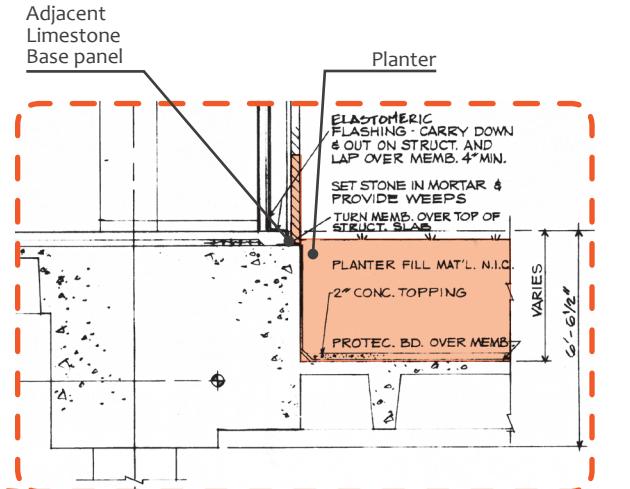


Figure C.07: Planter and Limestone Base Detail



Figure C.08: Photo 2E - Planter Base

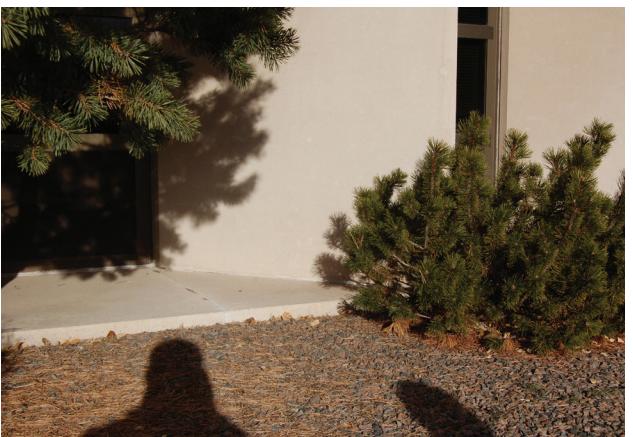


Figure C.09: Photo 2D - Planter Base



Figure C.10: Photo 2C - Planter Base



Appendix C Existing Conditions Assessment

PRECAST SOFFIT, PARAPET, AND FIN TUBE SYSTEM PROBE

Precast Soffit and Parapet

Intent

The intent of the precast soffit probe/exploration at the parapet is to selectively remove various building components to understand existing as-built conditions of soffit spaces and parapet assembly.

Goals

To understand the following as-built conditions:

- Problematic water infiltration into soffit space and building.
- The possible presence of mold.
- Condition of structural support elements.
- Extent and condition of insulation.
- Extent and condition of waterproofing flashing and weeps.
- Presence of soffit venting / drainage.
- Condition of fire protection on structural support members.
- Extend and condition of insulation on underside of roof slab within soffit area.
- Condition of parapet void and support.
- Confirm existence, condition and R-value of roof insulation.

Precast Soffit Fin Tube System

Intent

The intent of the precast soffit probe/exploration is to selectively remove various building components to understand existing as-built conditions of soffit spaces and interior fin tube system.

Goals

To understand the following as-built conditions:

- Problematic water infiltration into soffit space and building.
- Existence of mold in soffit space and between fin tube system and window.
- Condition of structural support elements for precast soffit elements.
- Extent and condition of insulation.
- Extent and condition of waterproofing, flashing and weeps.
- Presence of soffit venting / drainage.
- Condition of fire protection on structural support members.
- Confirm existence and condition of continual insulation, waterproofing and fire protection at typical exterior column locations.

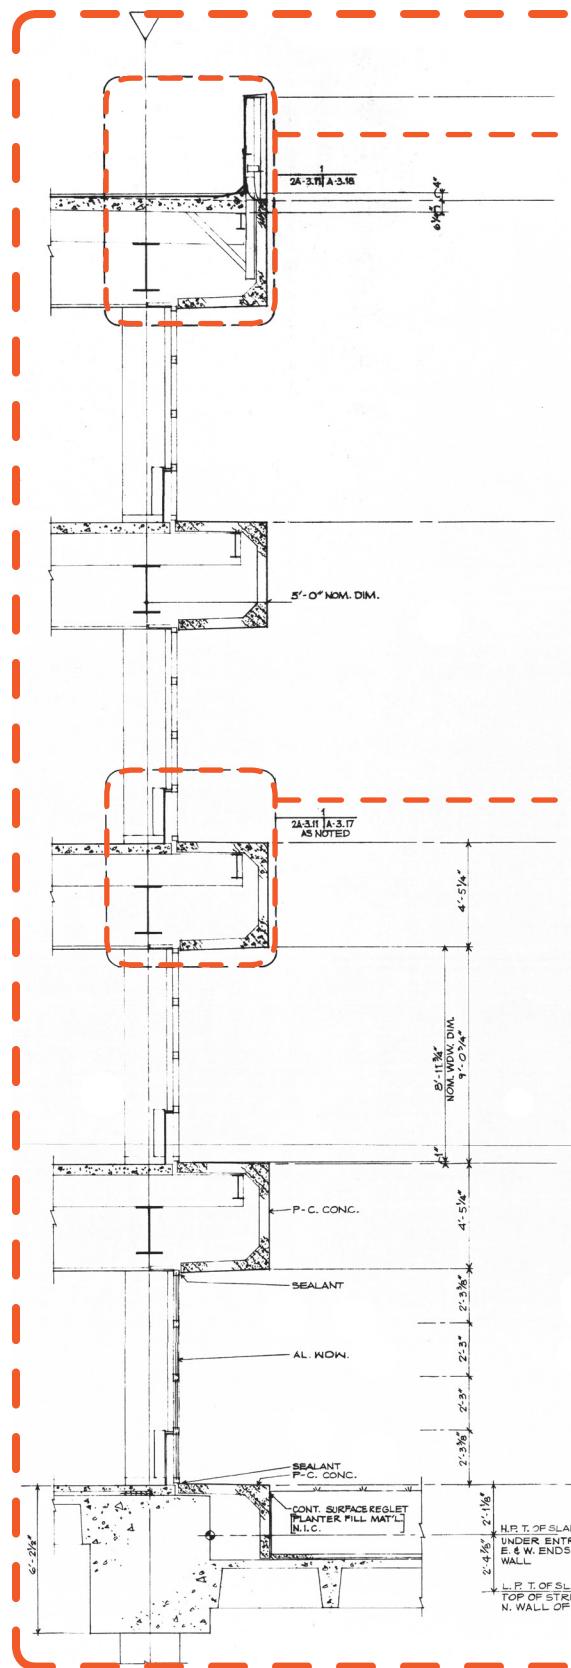


Figure C.11: Typical Wall Section

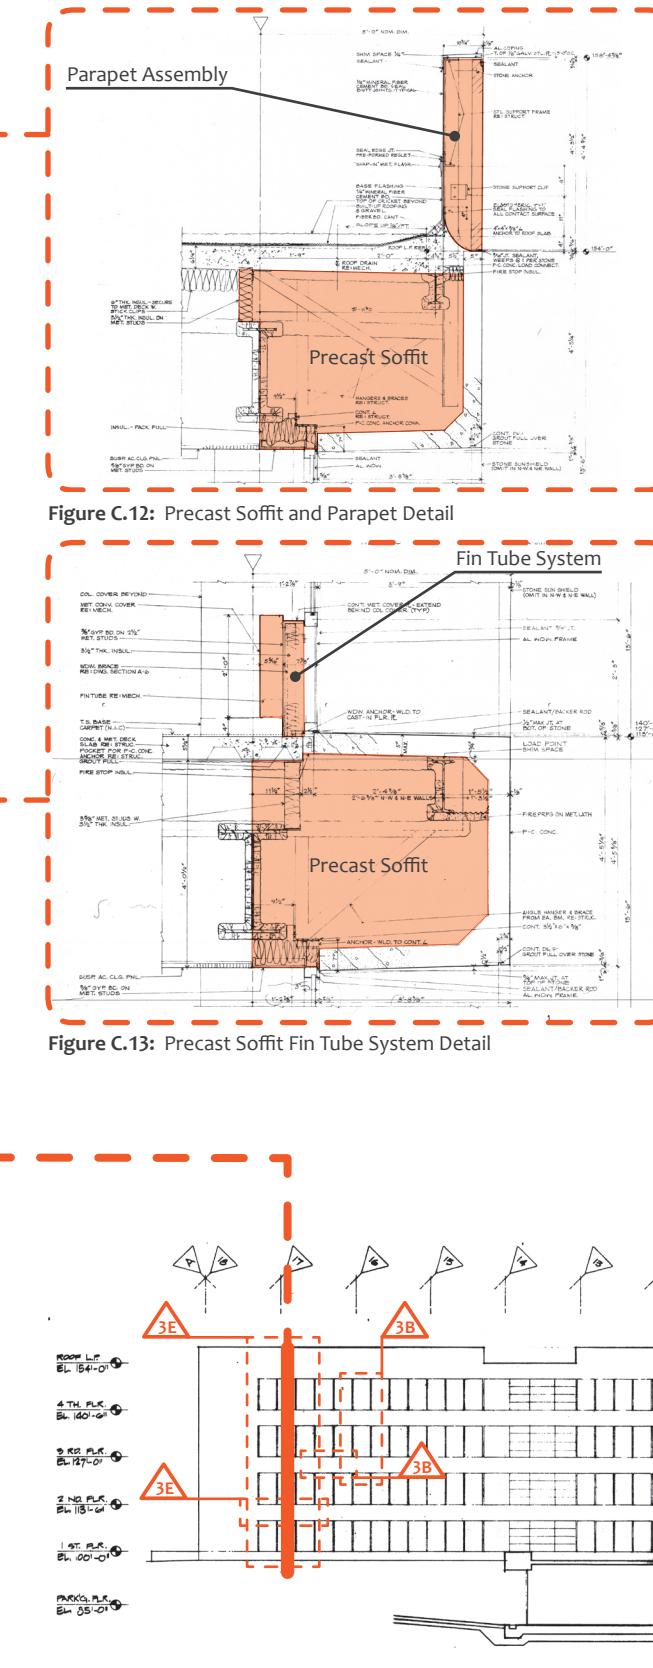


Figure C.12: Precast Soffit and Parapet Detail

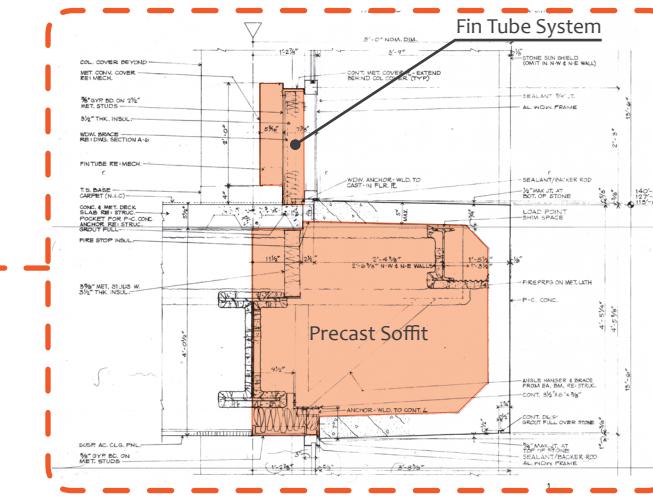


Figure C.13: Precast Soffit Fin Tube System Detail

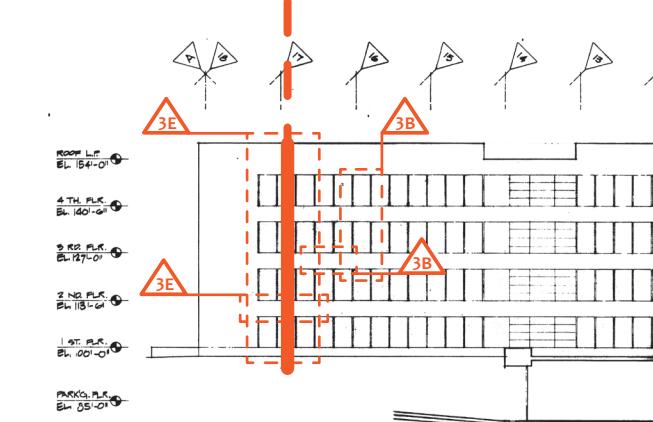


Figure C.14: Elevation 3A - Partial South Elevation



Figure C.15: Photo 3C - Exterior Precast Soffit



Figure C.16: Photo 3D - Exterior Precast Soffit



Figure C.17: Photo 3E - Precast Fin System



Figure C.18: Photo 3C - Precast Fin System



Figure C.19: Photo 3F - Overall West Elevation



Appendix C Existing Conditions Assessment

EXPANSION JOINT AT GARAGE

Intent

The intent of the expansion joint at garage probe/exploration is to selectively remove/excavate existing site material at three locations to understand as-built conditions.

Goals

- To understand the following as-built conditions:
- Existing condition of the expansion joint.
- Extent and condition of waterproofing and flashing.
- Interface of horizontal to vertical expansion joint [planter to wall].
- Interface of planter materials at expansion joint.

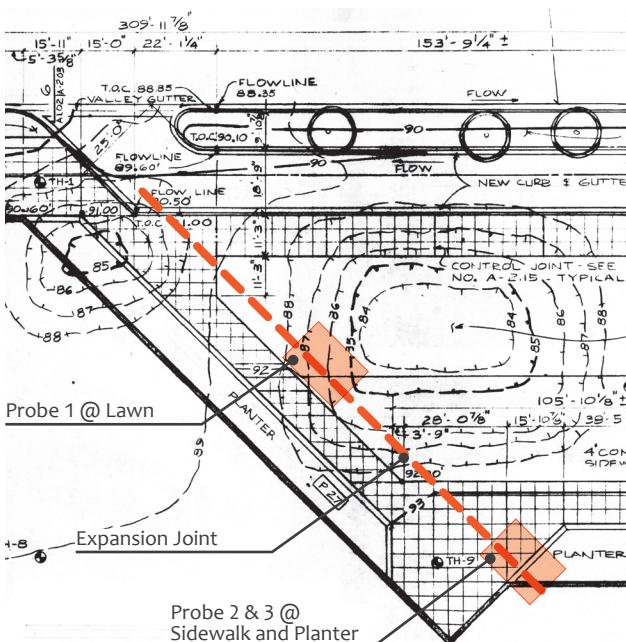


Figure C.29: Plan 5B - Partial Site Plan

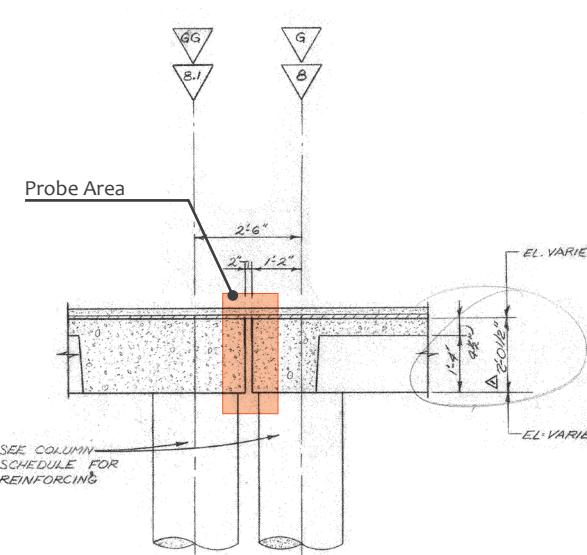


Figure C.30: Detail 5C - Expansion Joint at Garage



Figure C.32: Photo 5D - Parking Garage



Figure C.33: Photo 5F - Expansion Joint in Garage

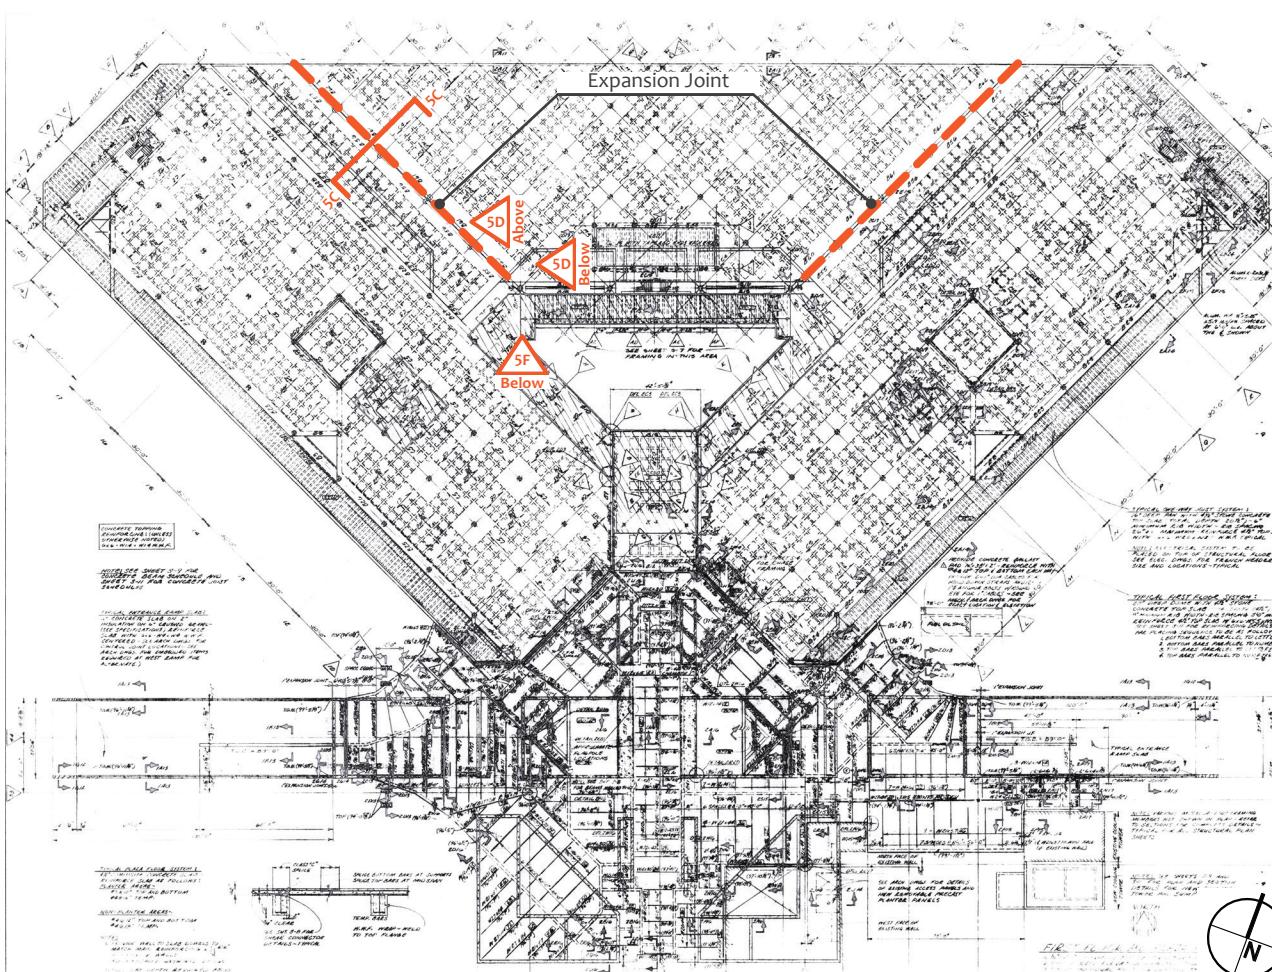


Figure C.31: Plan 5A - First Level Structural Floor Plan



Figure C.34: Photo 5E - North East Façade of Herschler Building



Appendix C Existing Conditions Assessment

PLAZA DECK AND CONNECTOR

Expansion Joint at Garage

Intent

The intent of the Plaza deck / connector probe / exploration is to selectively remove / excavate existing site material at 3 locations to understand as-built conditions at perimeter foundation wall from top of plaza deck to bottom of mat slab.

Goals

To understand the following as-built conditions:

- Extent and condition of waterproofing, flashing, vertical drainage layers, insulation, protection board and perimeter drainage.
- Interface of vertical waterproofing of perimeter wall to plaza deck waterproofing membrane.
- Plaza deck to waterproofing membrane layer sequence.
- Horizontal extent of foundation system as-built dimensions.

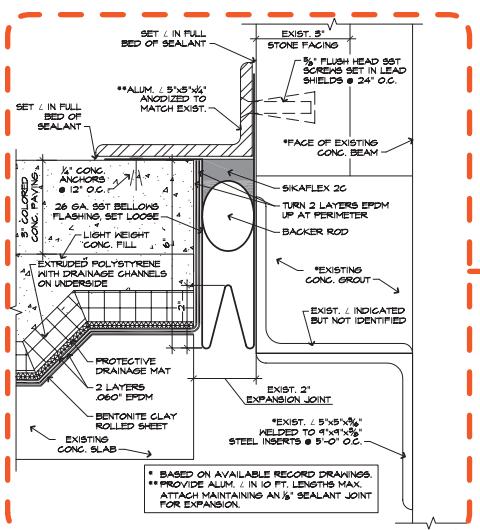


Figure C.35: Detail 5C - Expansion Joint

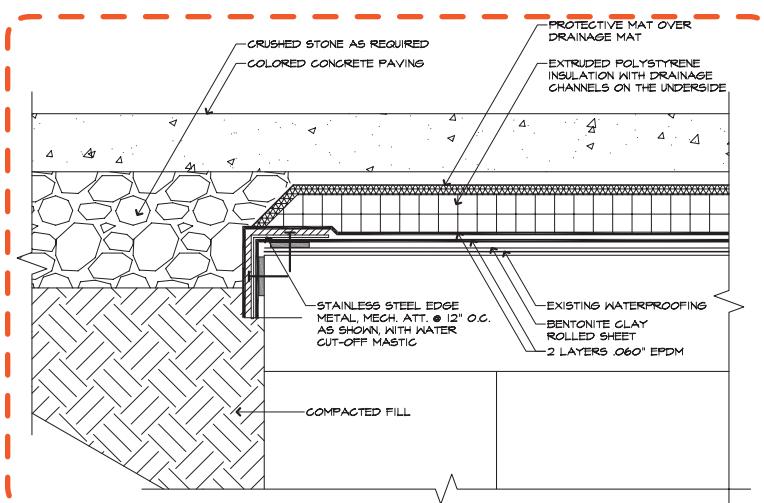


Figure C.36: Detail 5D - Waterproofing Detail at Plaza



Figure C.37: Photo 5B - Plaza Deck and Connector


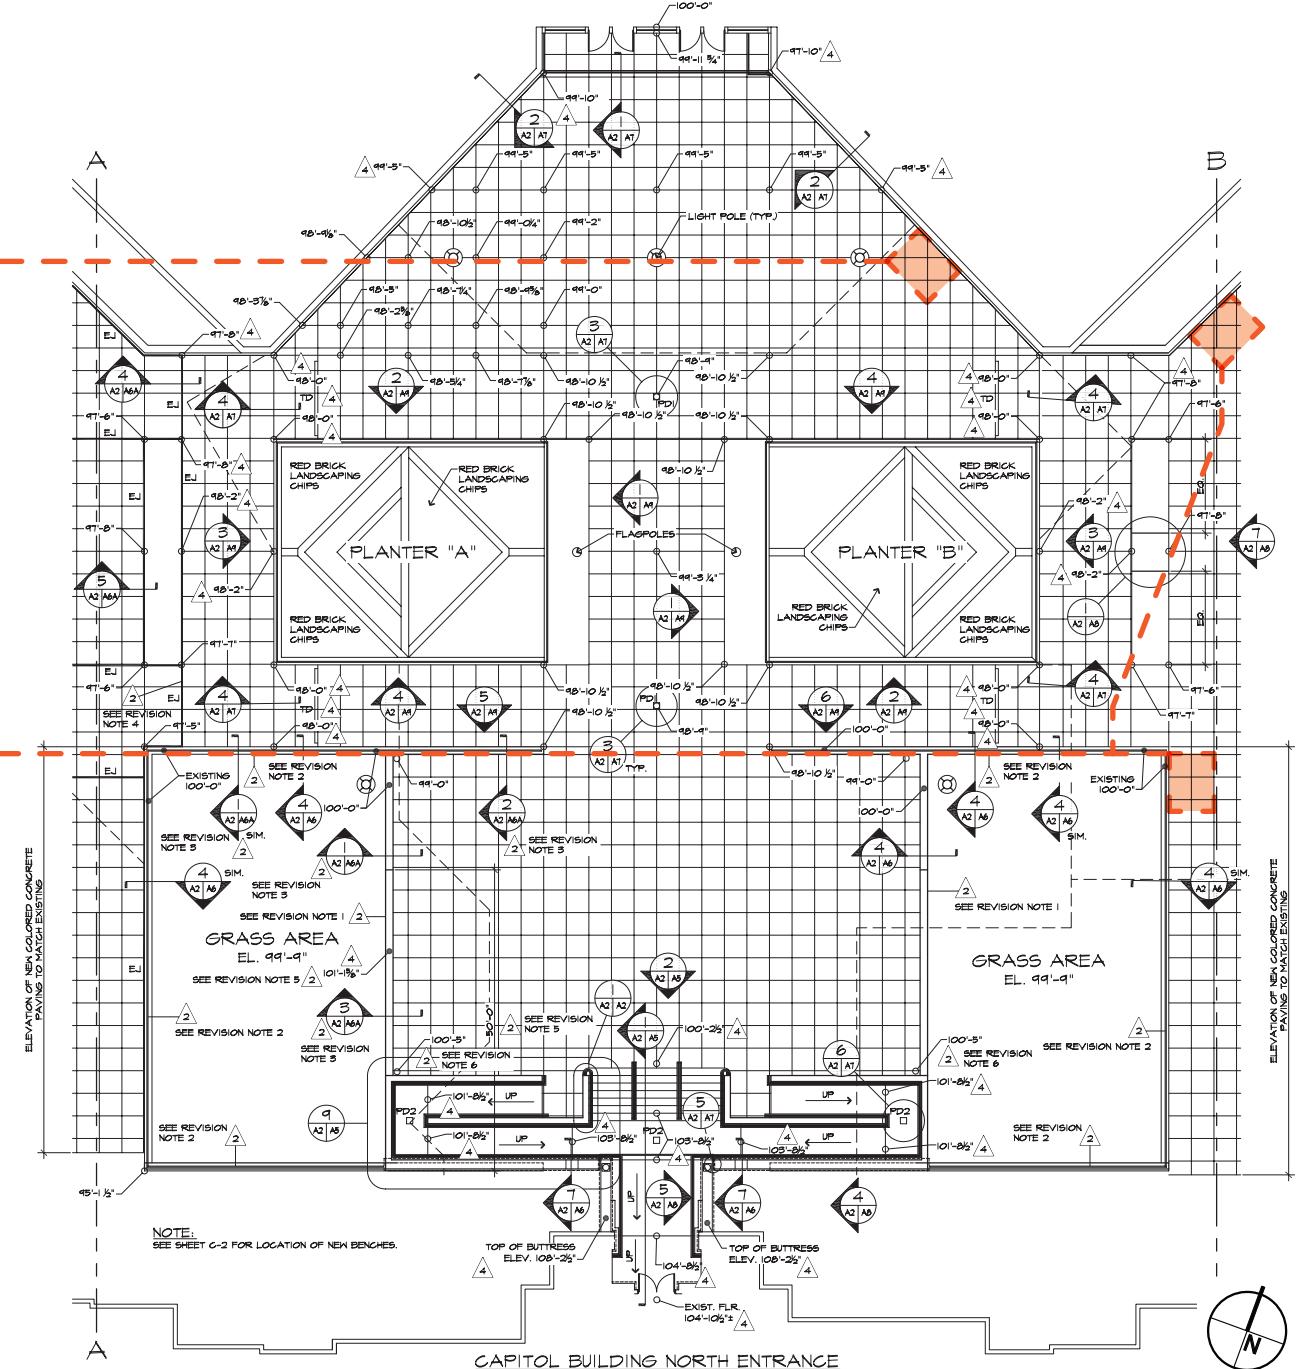


Figure C.38: Plan 5A - Plaza Deck/Connector Partial Site Plan



Appendix C Existing Conditions Assessment

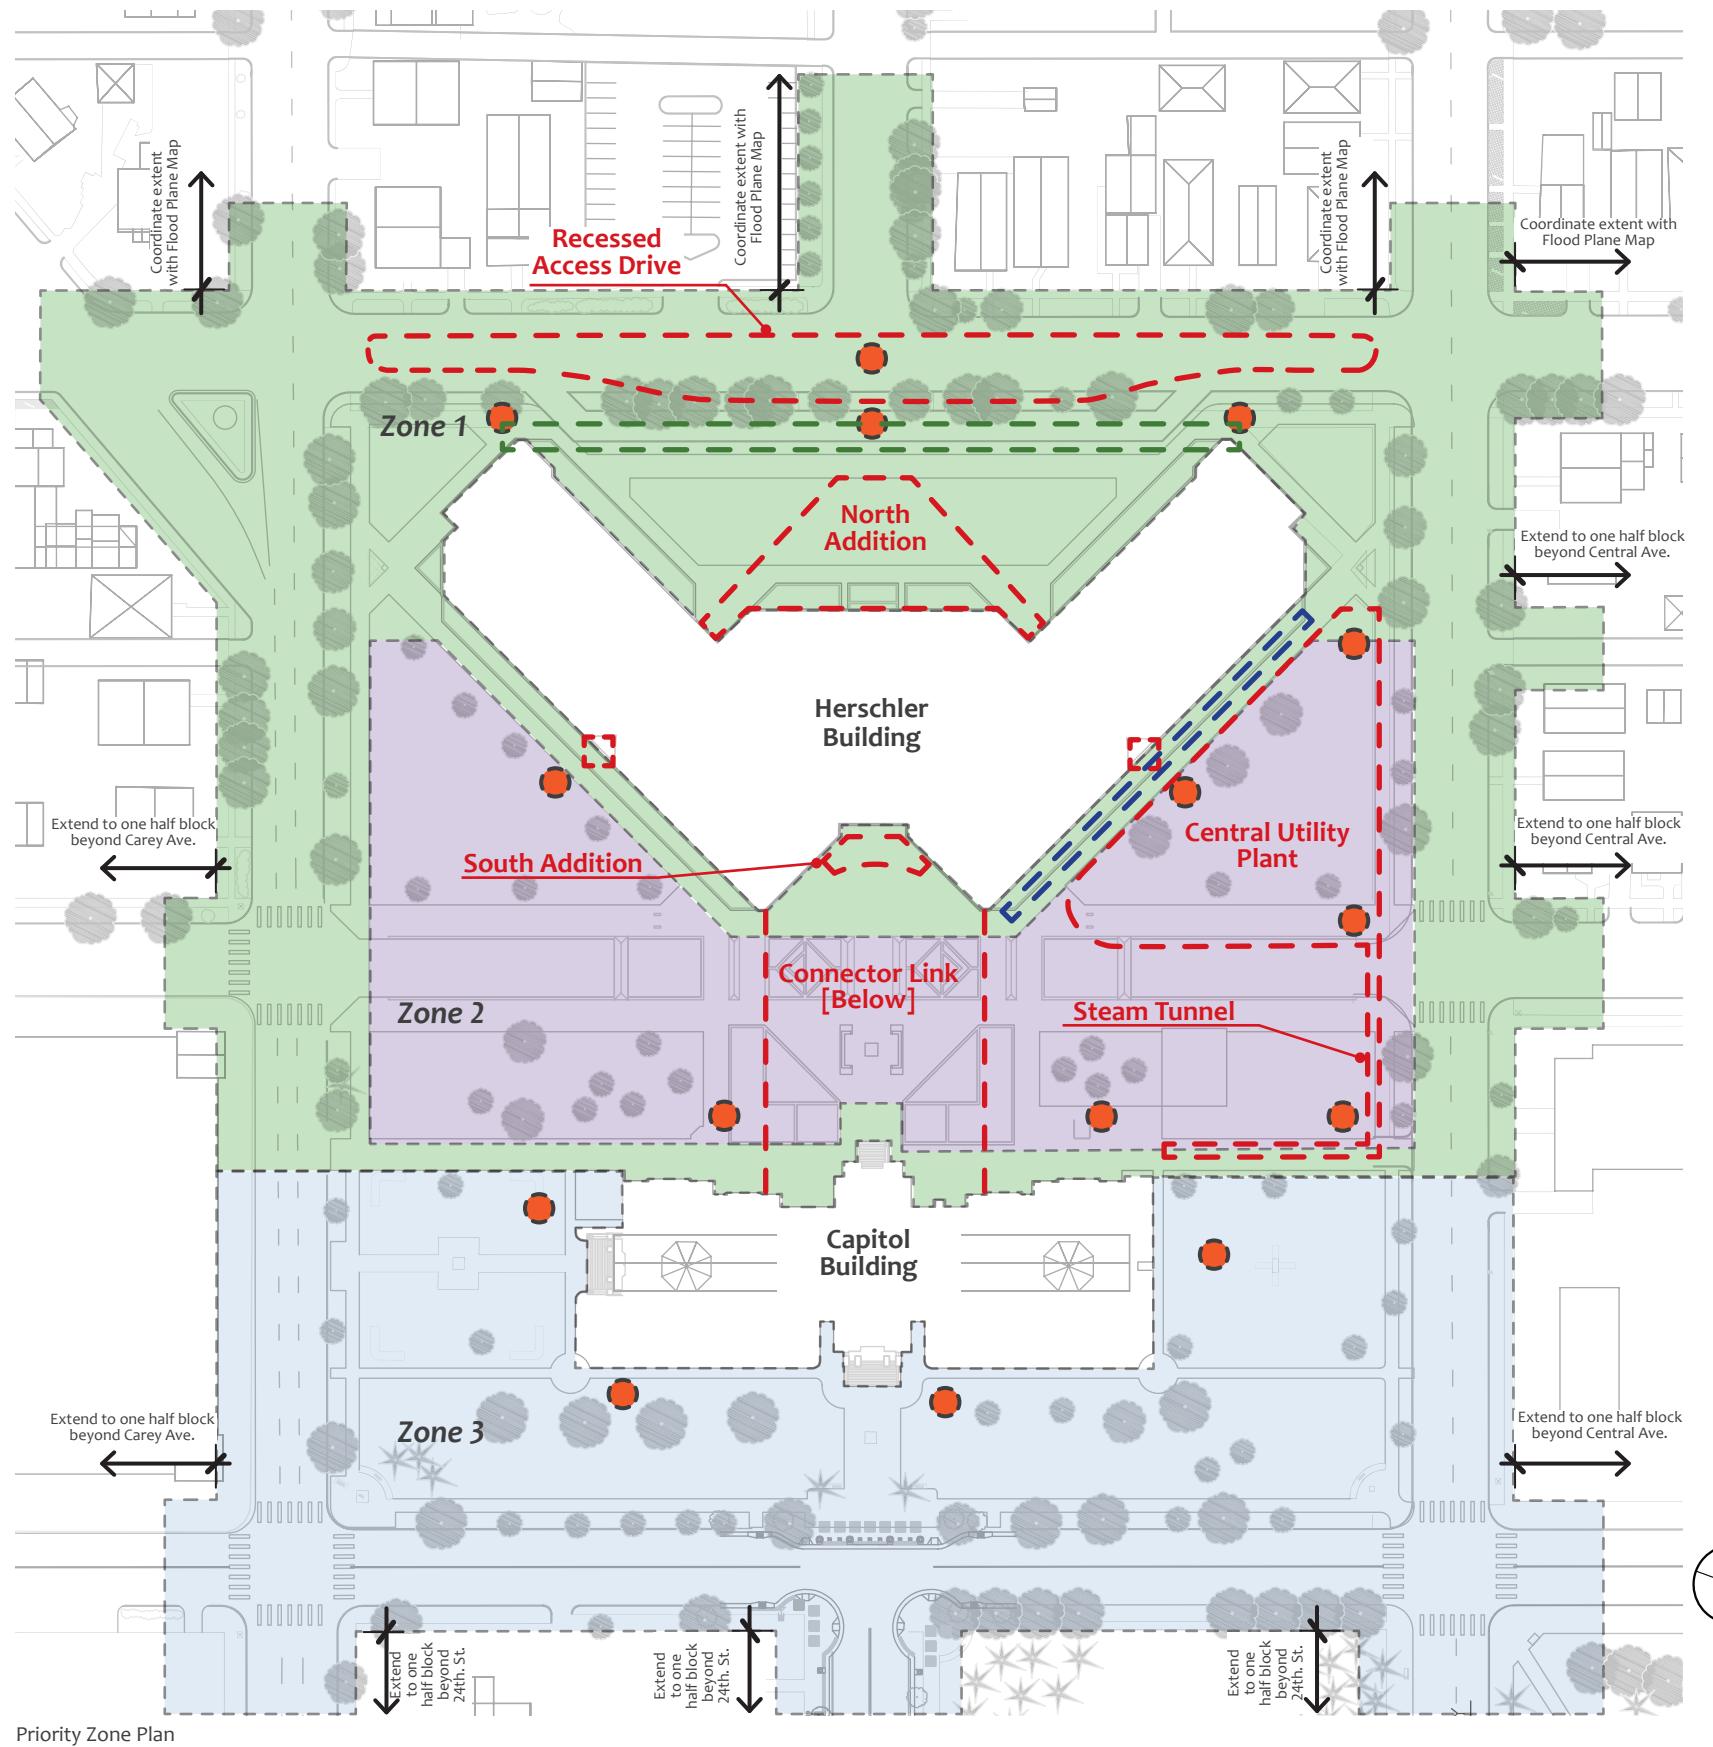

THIS PAGE INTENTIONALLY LEFT BLANK

